


B M ELEV-1085 582-PK NAIL IN
NW CB RET HIGHLANDER AND
SUGARLOAF DR.
1102.51-PK IN SW CB RET HIGHLANDER DR. AND FLANDERS RD
FB 57/1-26
SCALE HOR 1"=40'
SCALE VERT 1"=4'

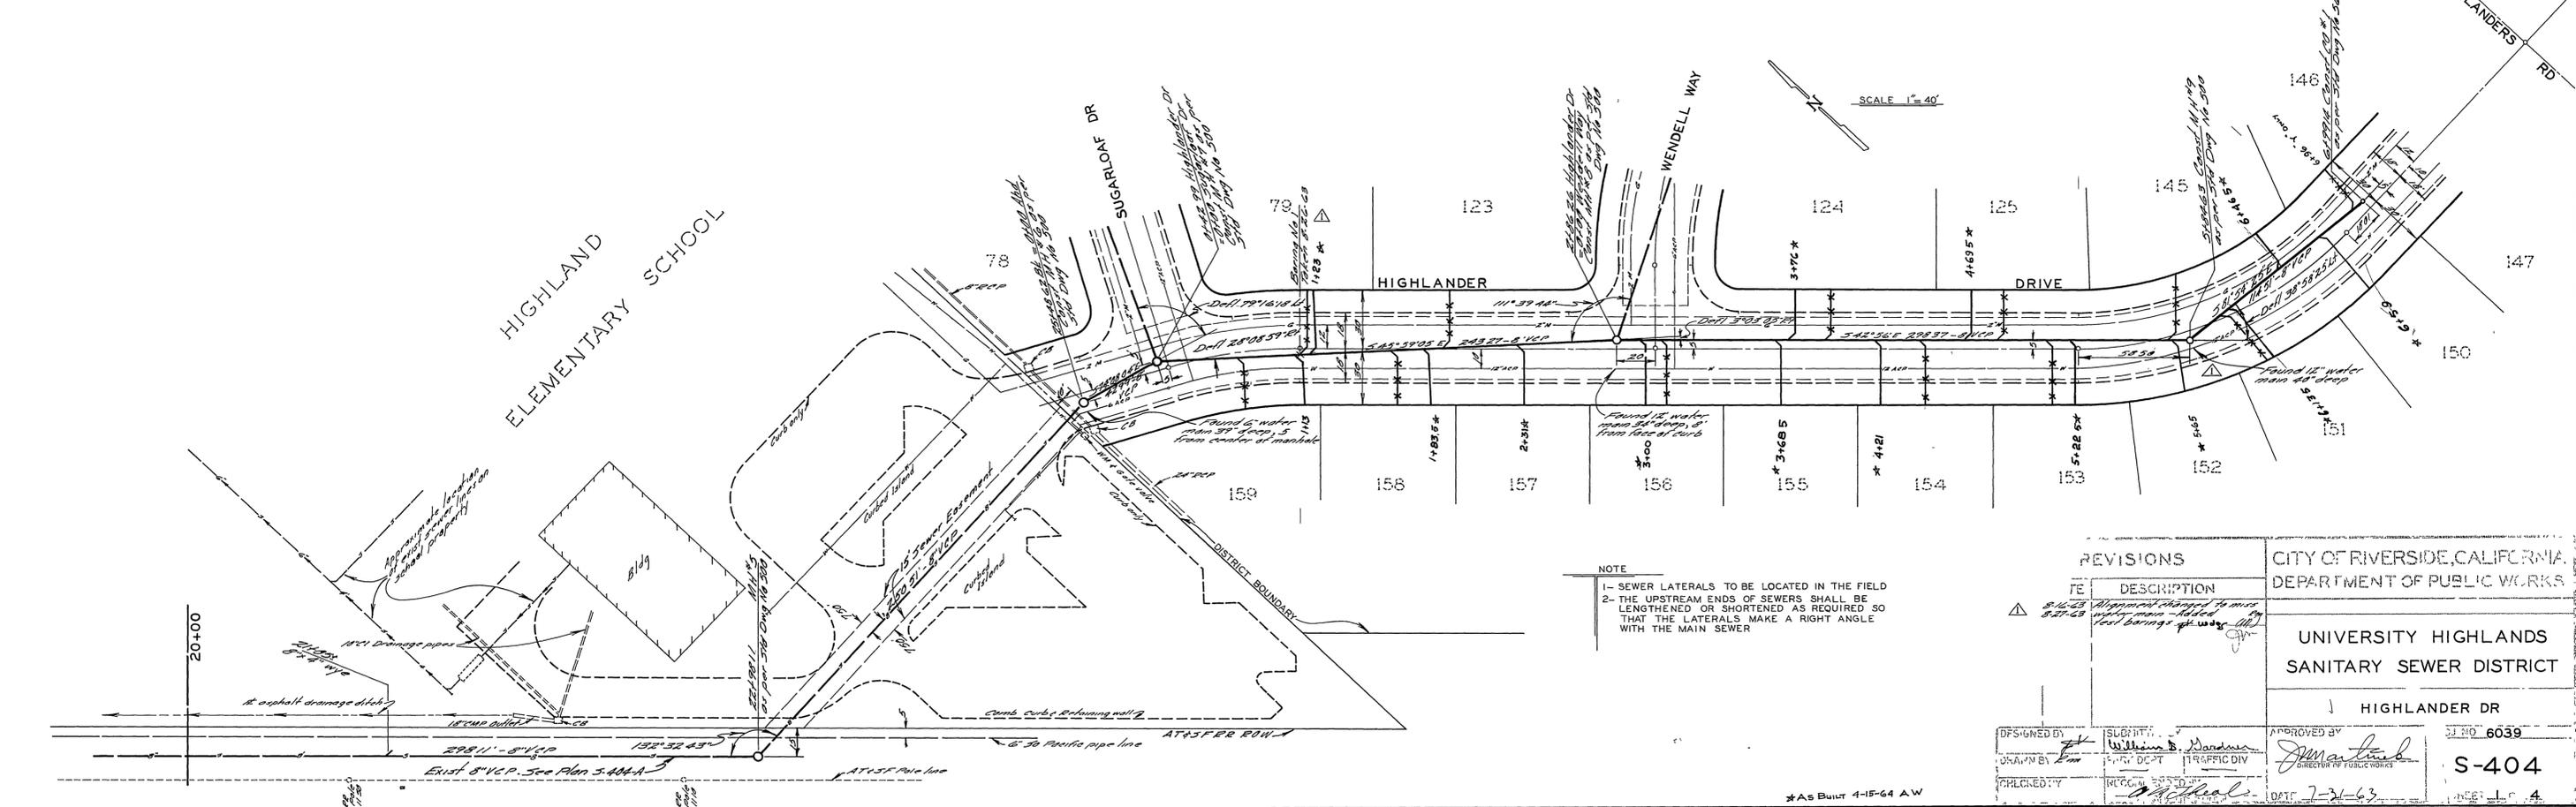

NOTE
1- SEWER LATERALS TO BE LOCATED IN THE FIELD
2- THE UPSTREAM ENDS OF SEWERS SHALL BE LENGTHENED OR SHORTENED AS REQUIRED SO THAT THE LATERALS MAKE A RIGHT ANGLE WITH THE MAIN SEWER

REVISIONS

FE	DESCRIPTION
8-16-63	Alignment changed to meet
8-27-63	water main - added
	Test borings per utility


CITY OF RIVERSIDE, CALIFORNIA
DEPARTMENT OF PUBLIC WORKS

UNIVERSITY HIGHLANDS
SANITARY SEWER DISTRICT


HIGHLANDER DR

DESIGNED BY <i>[Signature]</i>	SUBMITTED BY <i>[Signature]</i>	APPROVED BY <i>[Signature]</i>	SI NO. 6039
DRAWN BY <i>[Signature]</i>	TRAFFIC DIV.	DIRECTOR OF PUBLIC WORKS	S-404
CHECKED BY <i>[Signature]</i>	DATE 7-31-63		



*As Built 4-15-64 AW

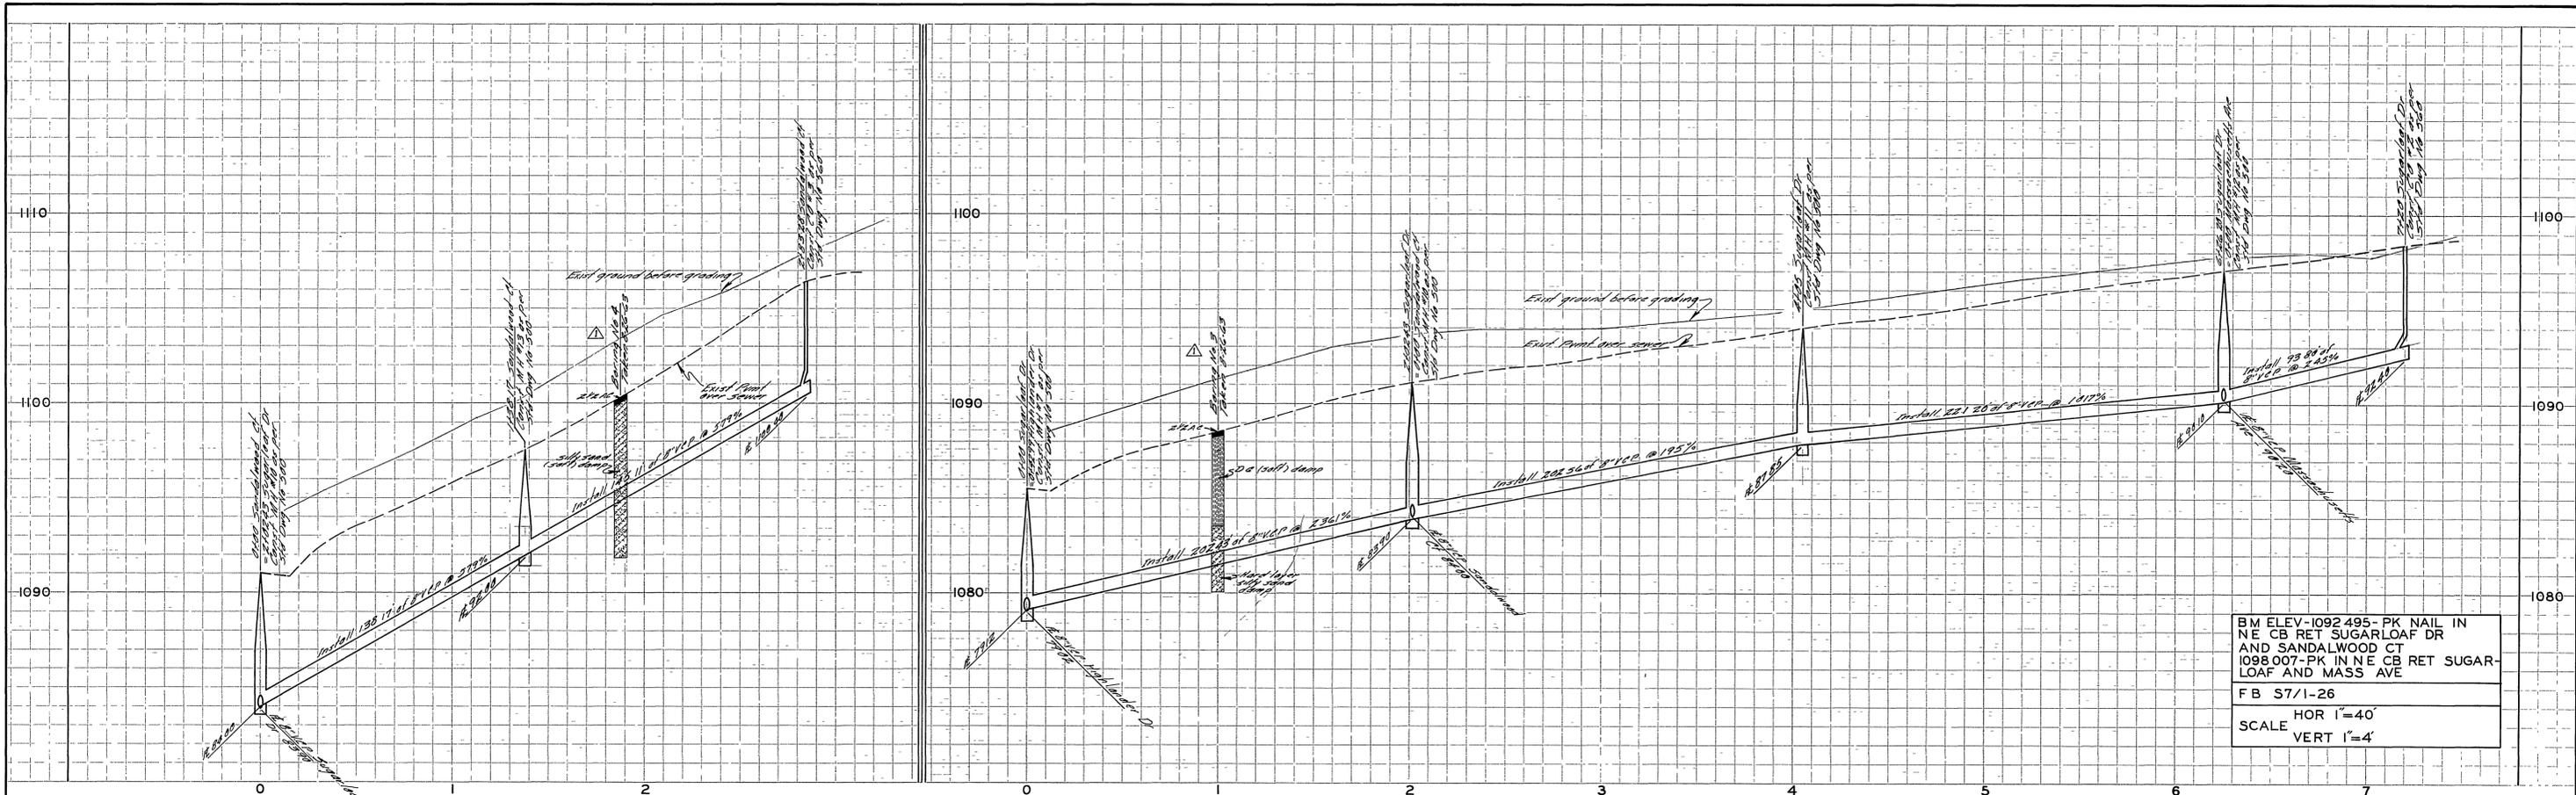

BM ELEV-1092.495- PK NAIL IN
 NE CB RET SUGARLOAF DR
 AND SANDALWOOD CT
 1098.007-PK IN NE CB RET SUGAR-
 LOAF AND MASS AVE
 FB S7/1-26
 HOR 1"=40'
 SCALE VERT 1"=4'

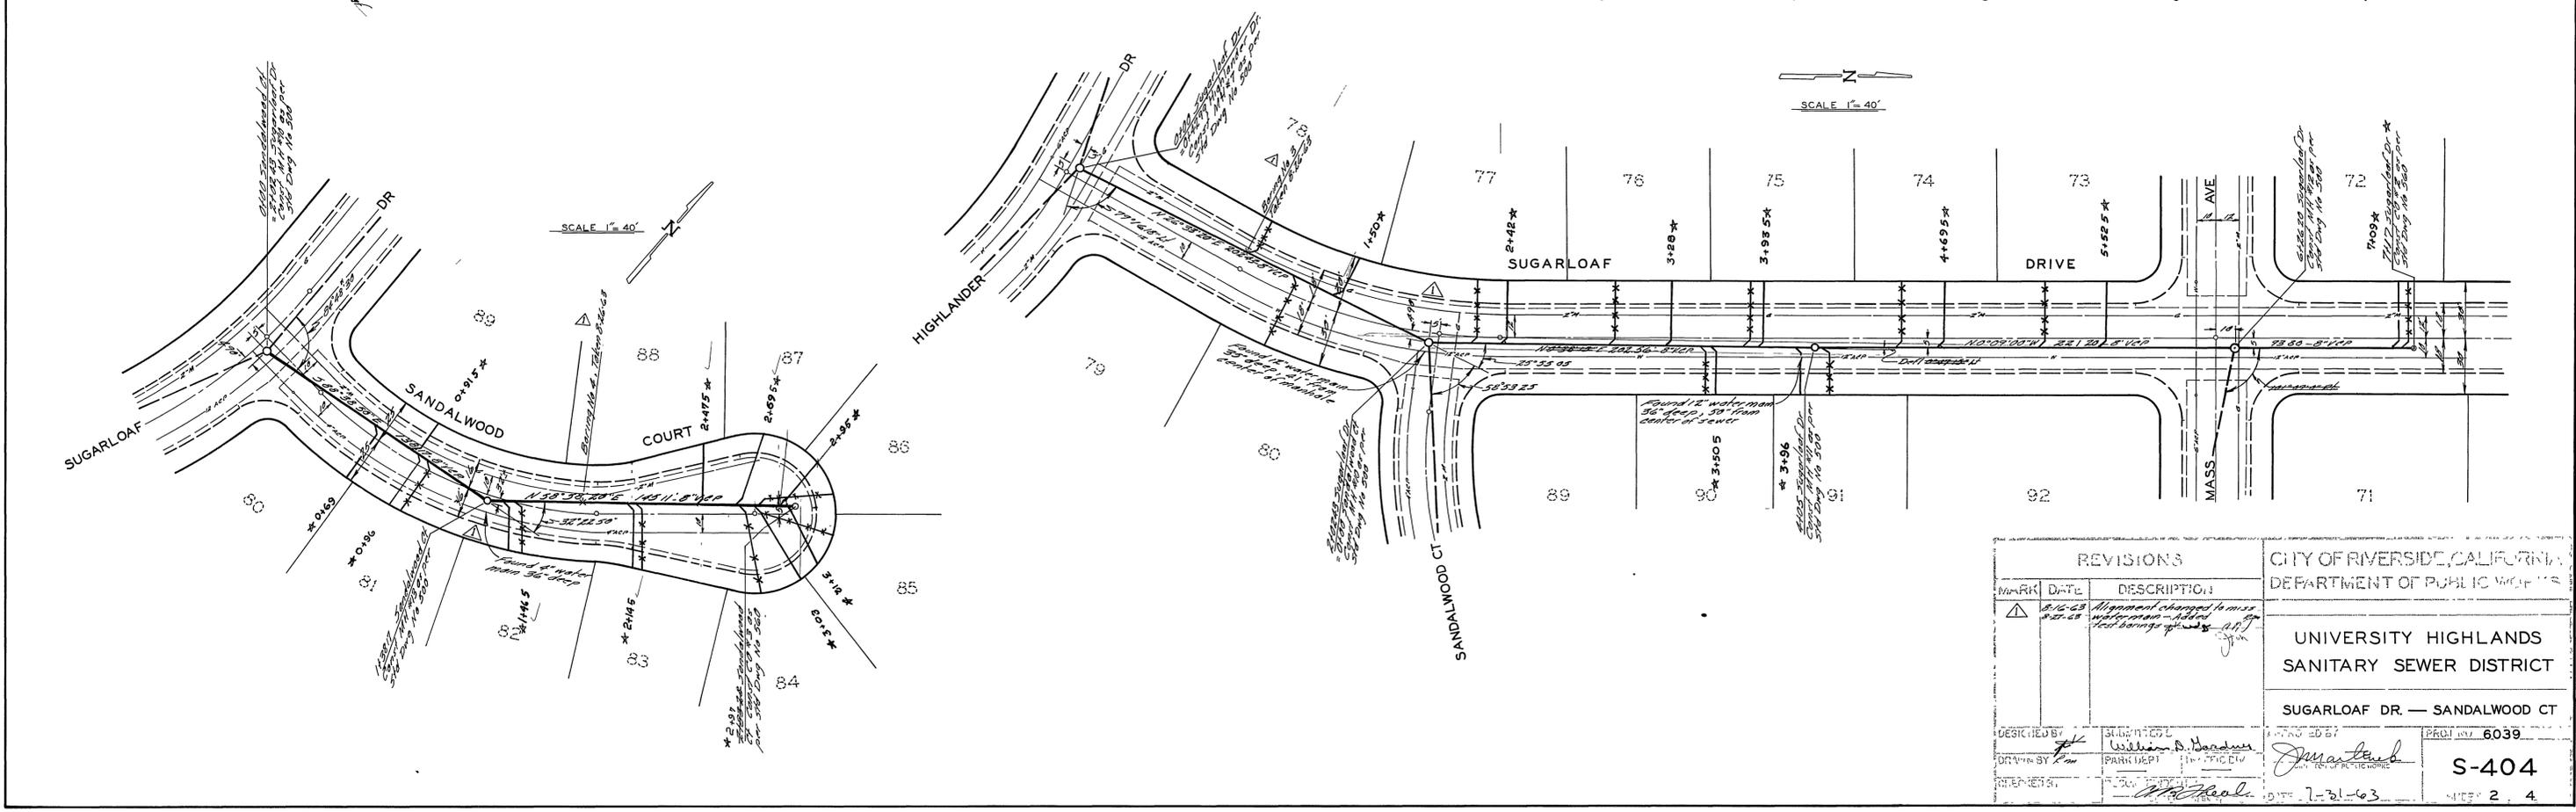


REVISIONS		CITY OF RIVERSIDE, CALIFORNIA DEPARTMENT OF PUBLIC WORKS
MARK	DATE	
△	8/12/03	Alignment changed to meet requirements of utility field bearings of 117'
		UNIVERSITY HIGHLANDS SANITARY SEWER DISTRICT
		SUGARLOAF DR. — SANDALWOOD CT
DESIGNED BY	WILLIAM D. HANCOCK	PROJECT NO. 6039
DRAWN BY	WILLIAM D. HANCOCK	S-404
CHECKED BY	WILLIAM D. HANCOCK	DATE 7-21-03
		SHEET 2 OF 4

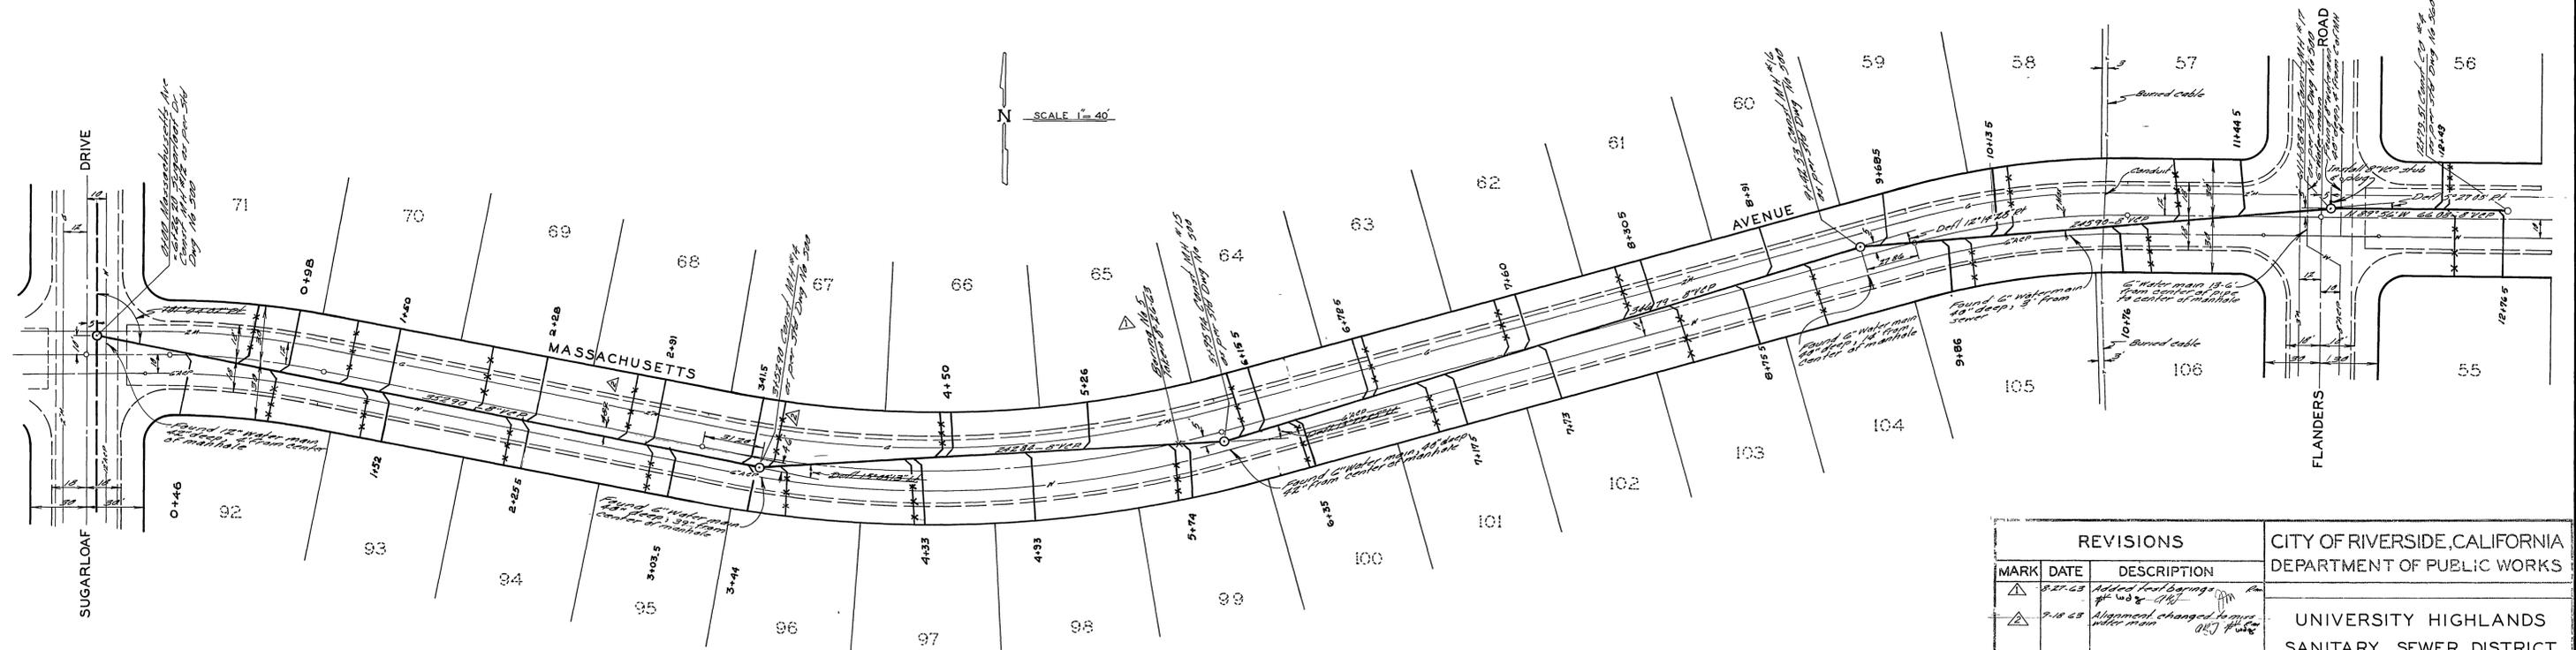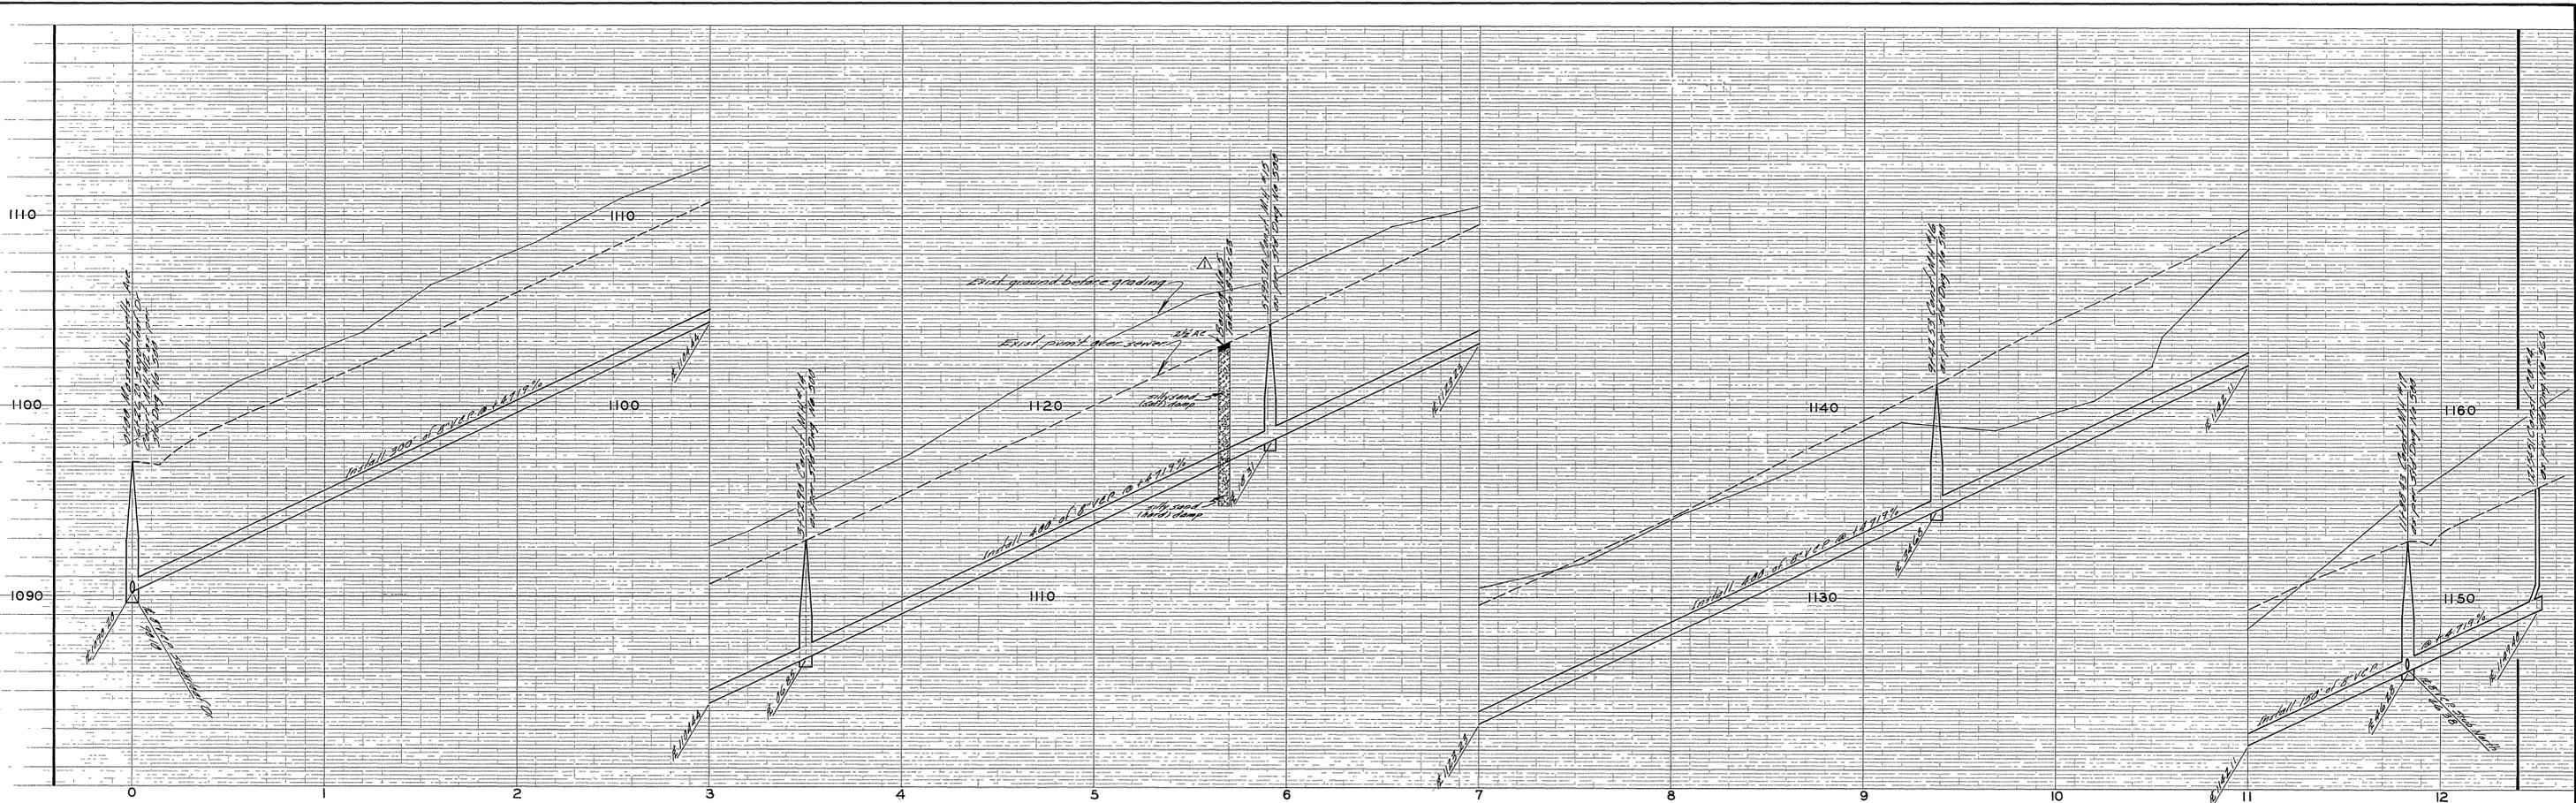

BM ELEV-1098007-PK NAIL IN
 NE CB RET SUGARLOAF DR AND
 MASS AVE
 1149 701-PK IN SLY CB MASS
 80± WLY OF FLANDERS RD
 FB S7/1-26
 HOR 1"=40'
 SCALE
 VERT 1"=4'

REVISIONS		
MARK	DATE	DESCRIPTION
△	8-27-63	Added final bearings to 63 & 64
△	9-18-63	Alignment changed to meet water main (see) 1149


CITY OF RIVERSIDE, CALIFORNIA
 DEPARTMENT OF PUBLIC WORKS
 UNIVERSITY HIGHLANDS
 SANITARY SEWER DISTRICT
 MASSACHUSETTS AVENUE
 PROJ NO 6039
 S-404
 SHEET 3 OF 4
 DATE 7-31-63

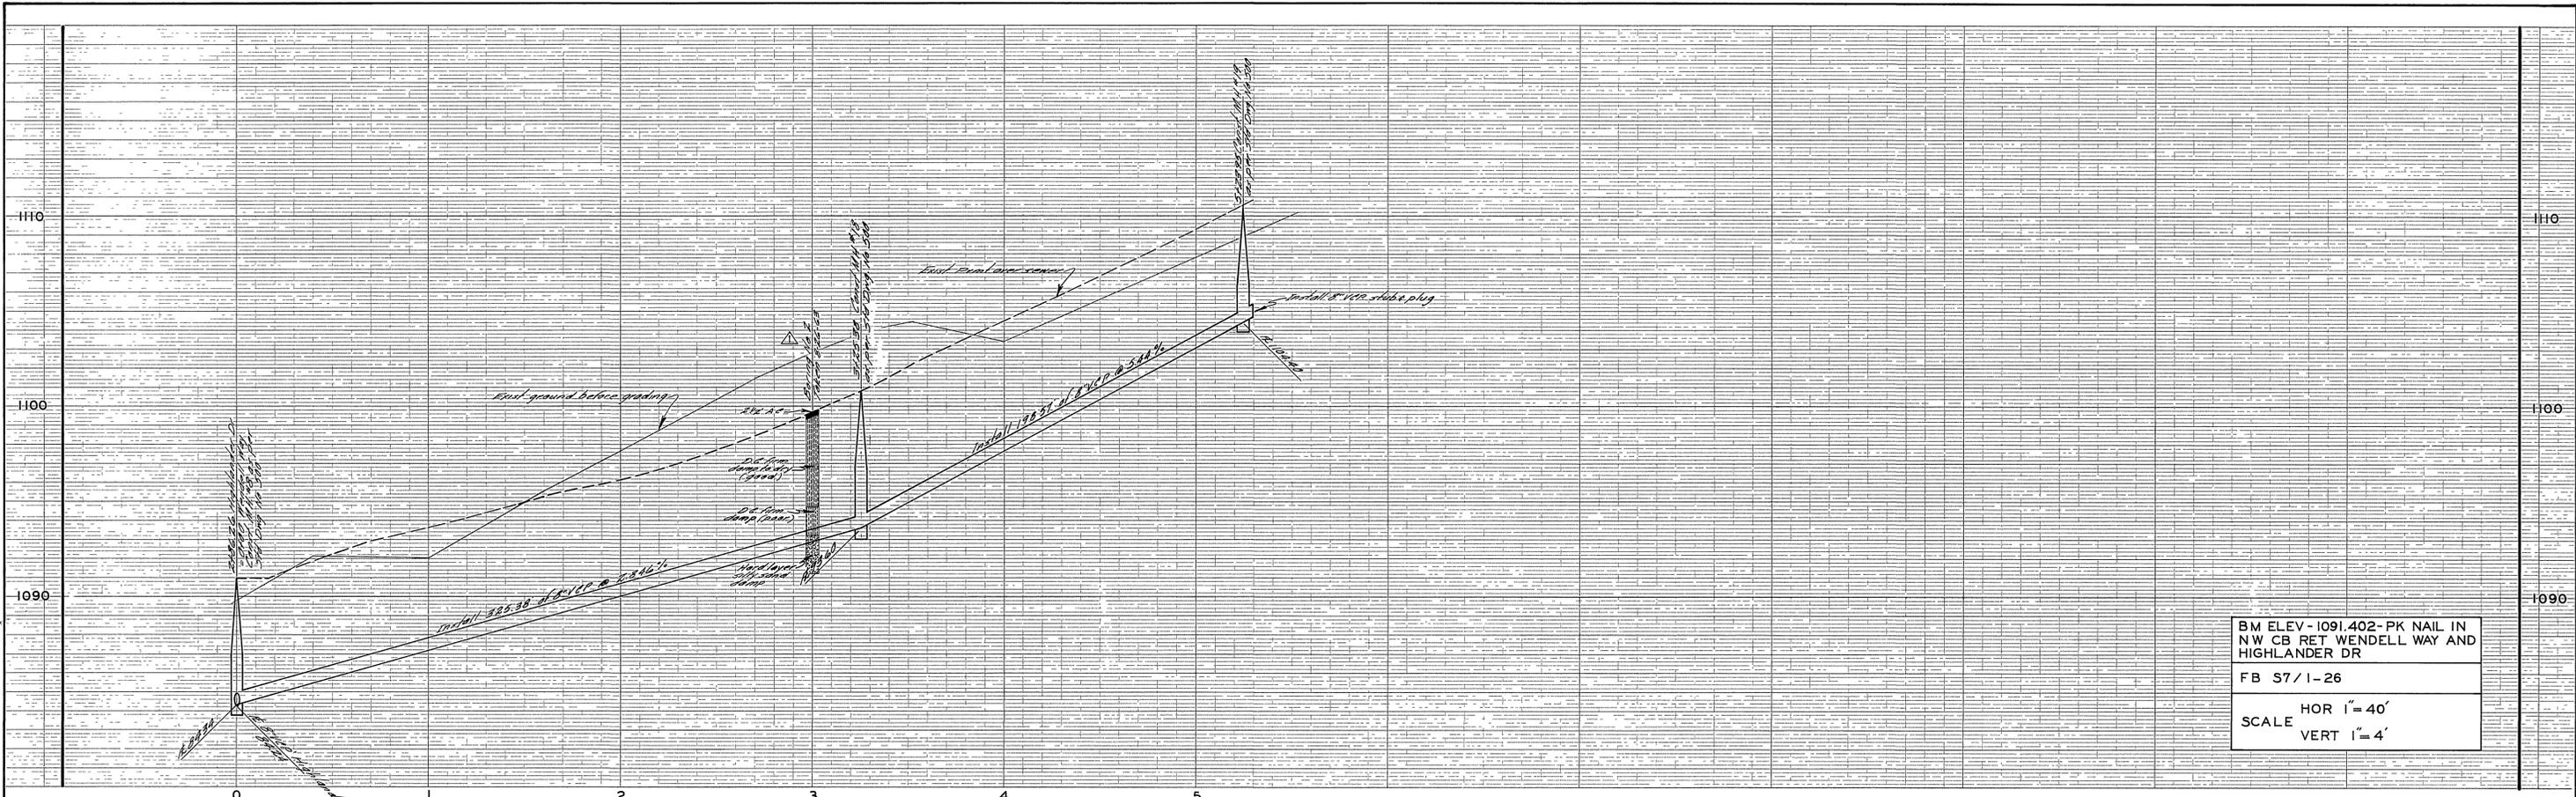

BM ELEV - 1091.402 - PK NAIL IN
NW CB RET WENDELL WAY AND
HIGHLANDER DR

FB 57/1-26

SCALE HOR 1" = 40'
VERT 1" = 4'

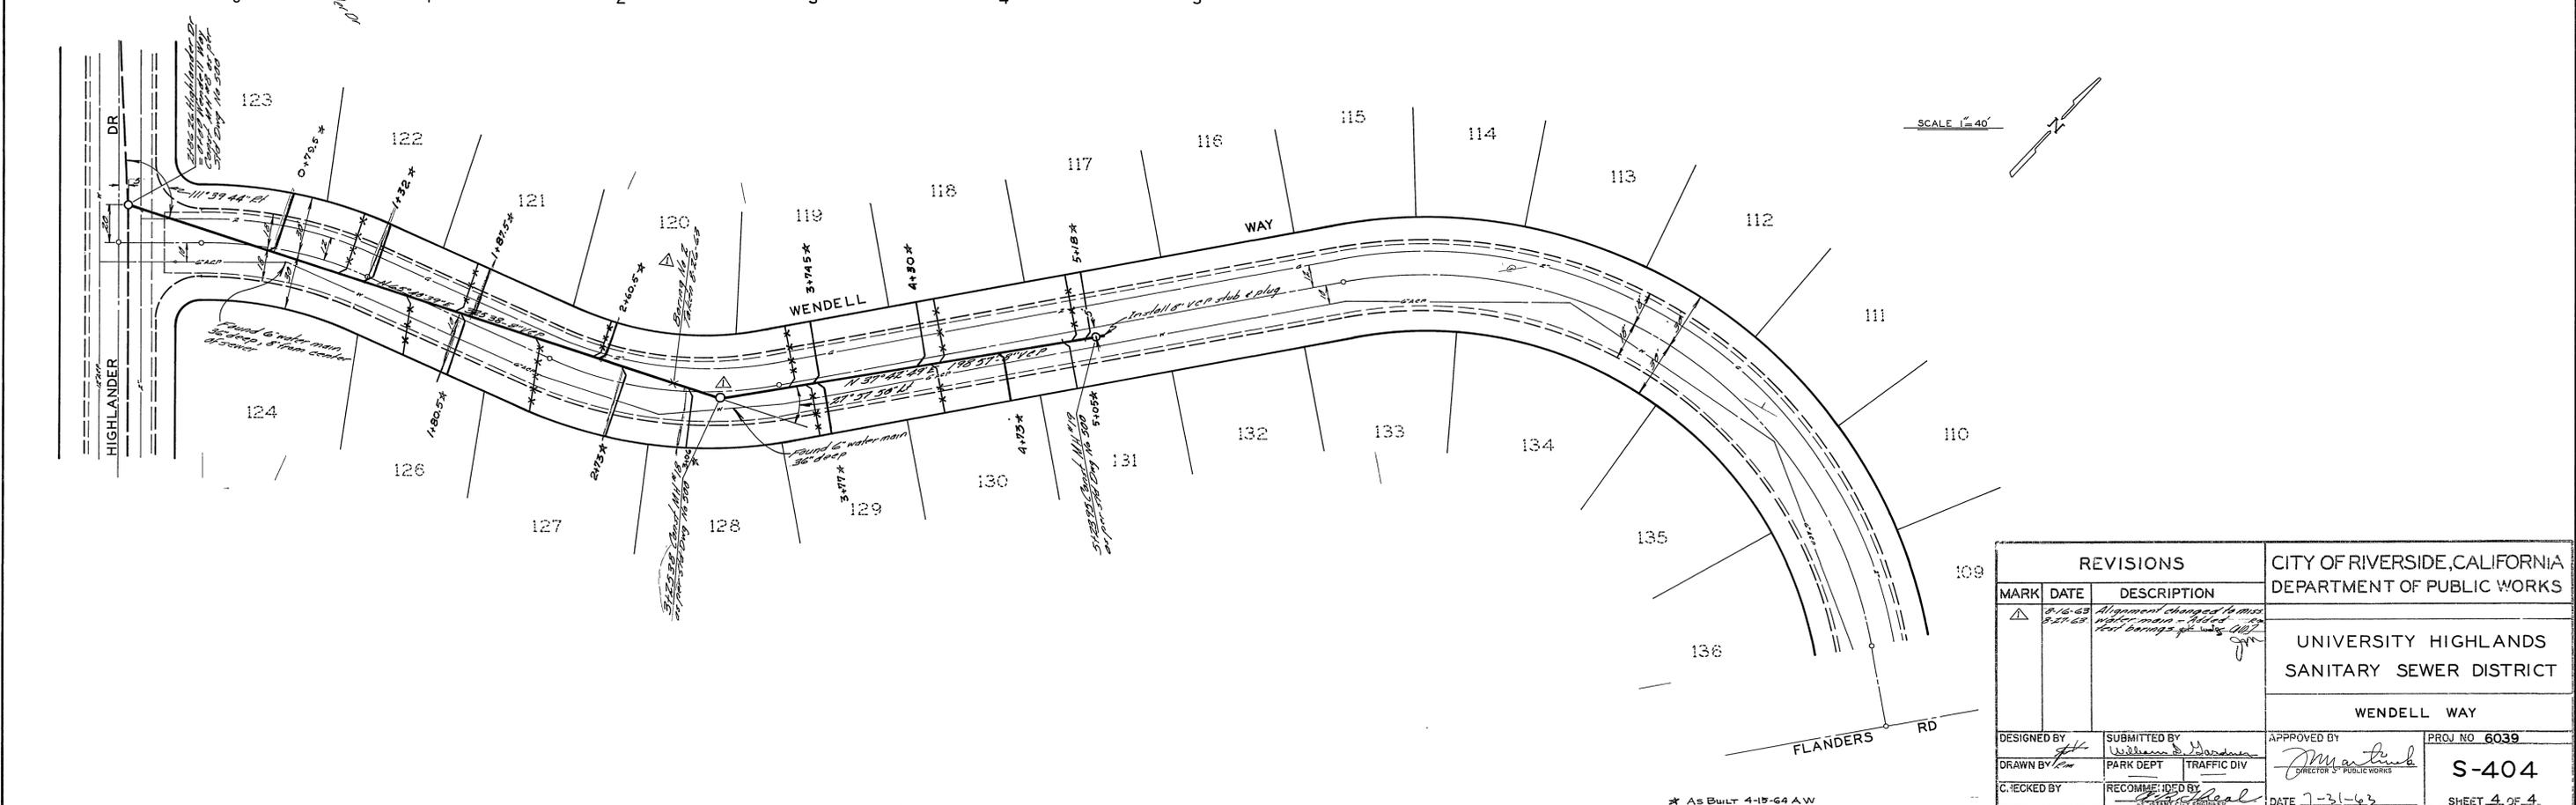

REVISIONS			CITY OF RIVERSIDE, CALIFORNIA DEPARTMENT OF PUBLIC WORKS	
MARK	DATE	DESCRIPTION		
△	8-15-63 8-27-63	Alignment changed to meet water main - Added 10' root barrier at water main	UNIVERSITY HIGHLANDS SANITARY SEWER DISTRICT	
			WENDELL WAY	
			PROJ NO 6039	
DESIGNED BY	SUBMITTED BY		APPROVED BY	
DRAWN BY	PARK DEPT TRAFFIC DIV		DIRECTOR OF PUBLIC WORKS	
CHECKED BY	RECOMMENDED BY		DATE 7-31-63	
			SHEET 4 OF 4	

* AS BUILT 4-15-64 A.W.